


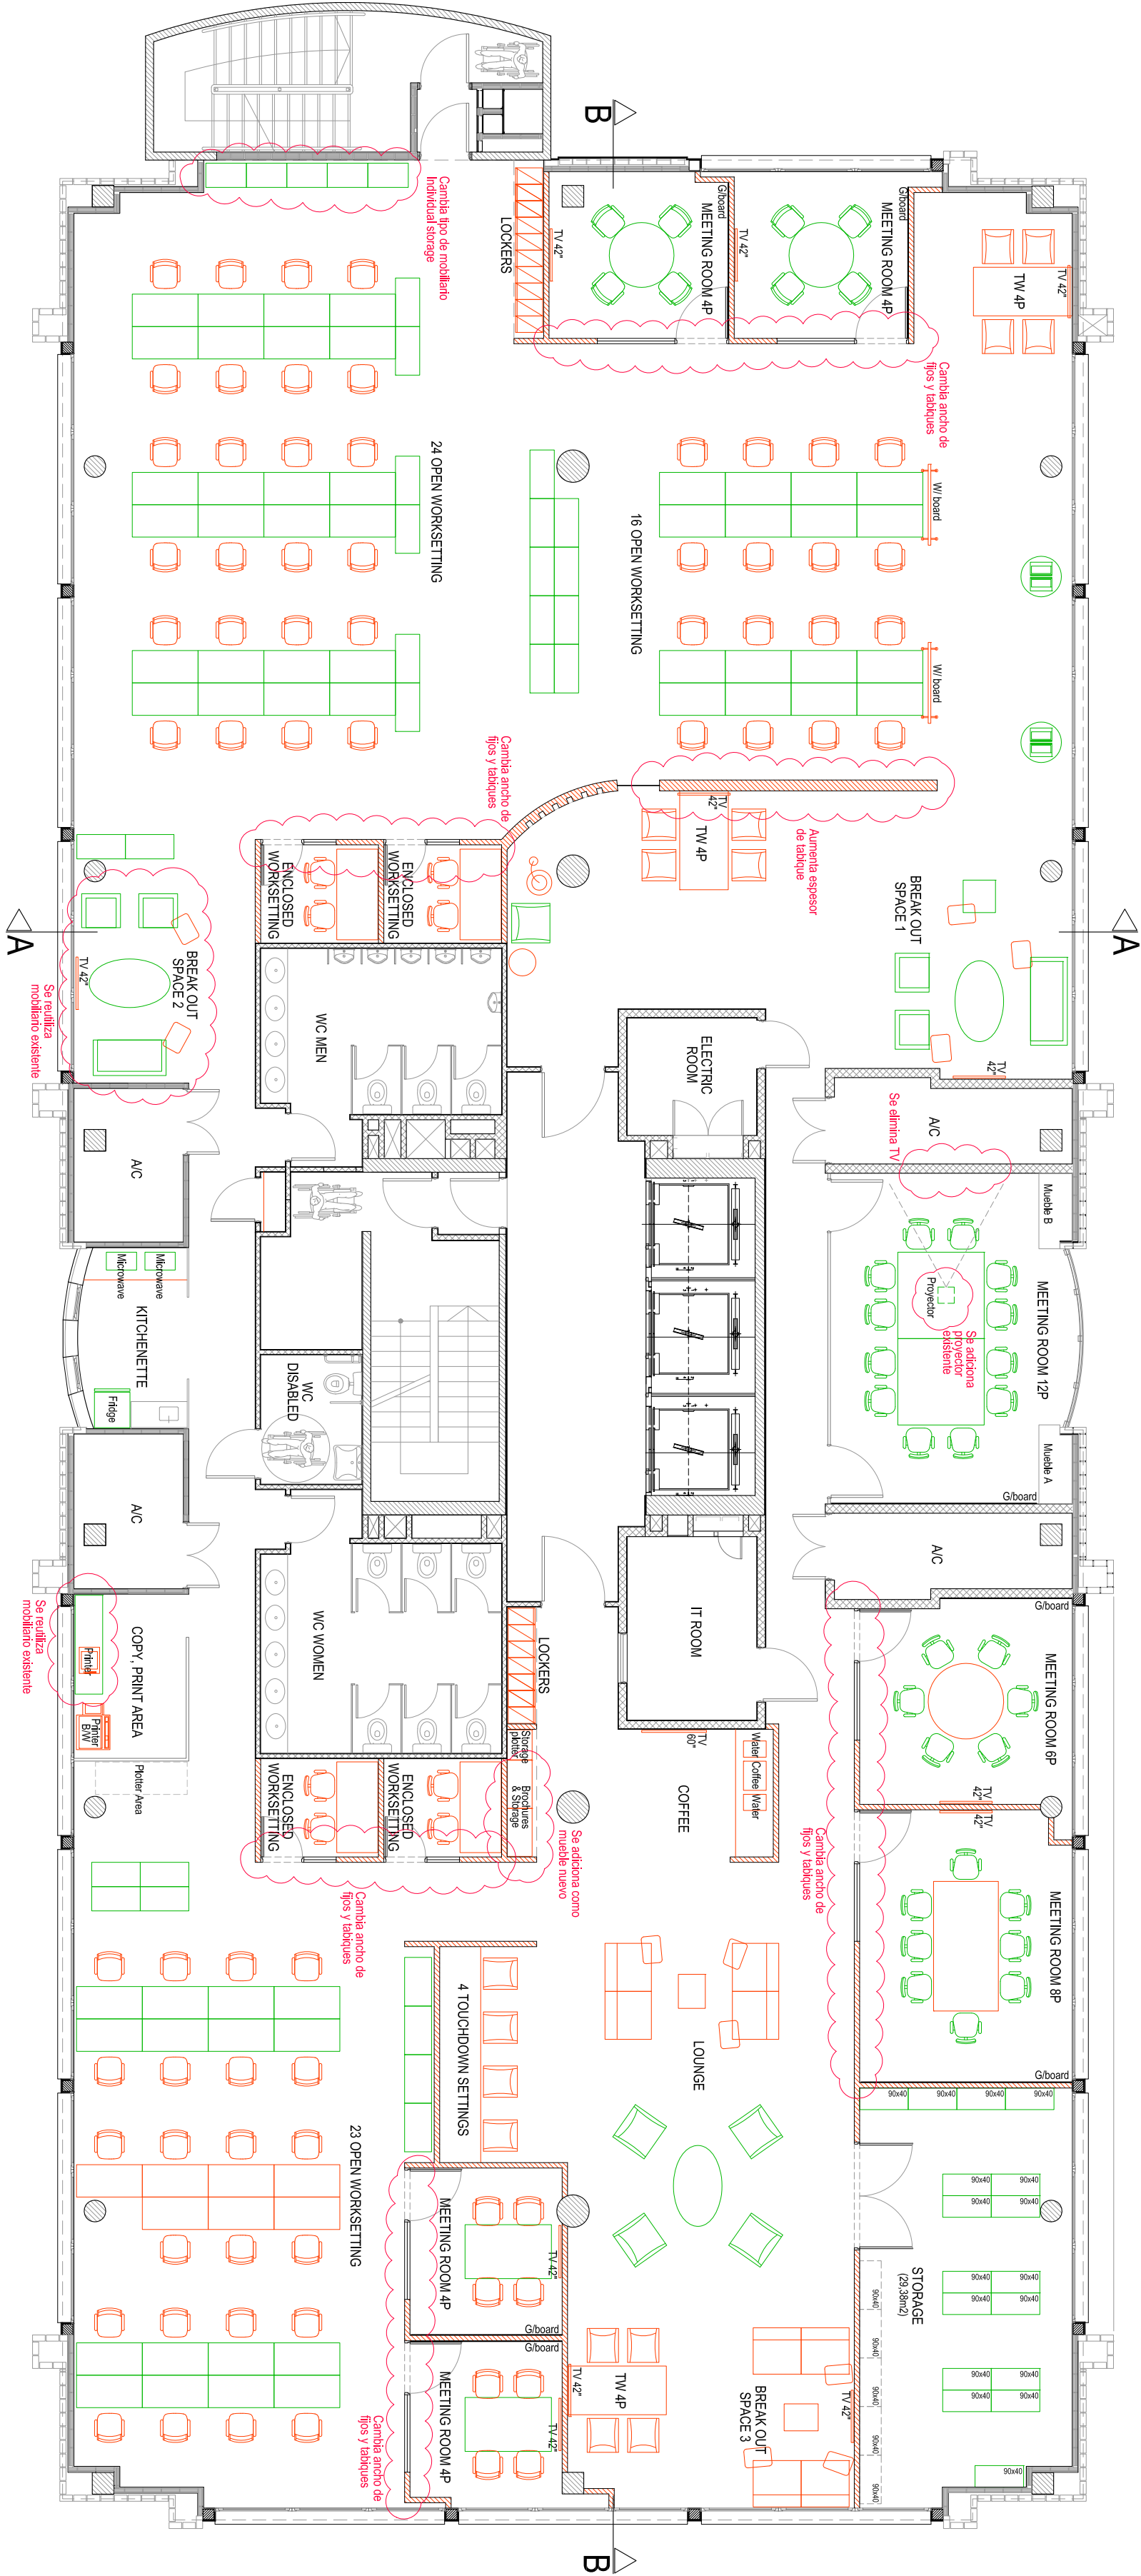

SPACE	PHILIPS		
	QUANT.	SEATS	TOTAL SEATS
Open Worksetting	63	63	71
Enclosed Worksetting	4	4	
Touchdown Worksetting	4	4	12
Touchdown Worksetting Others	3	12	
Meeting Room 4P	4	16	64
Meeting Room 6P	1	6	
Meeting Room 8P	1	8	
Meeting Room 12P	1	12	
Break Out Space / Lounge / Coffee	4	22	147
TOTAL SEATS			

SPACE	PHILIPS	
	QUANT.	TOTAL
Reception	0	0
Copy, Print Area	1	1
Brochures & Storage	1	1
IT Room	1	1
Electric Room	1	1
Storage (Sample room)	1	1
Individual Storage x 4un	25 x 4	100
Individual Storage x 1un (drawers)	5 x 1	5
Lockers x 4	17 x 4	68

	Nuevo
	Relocalizado
	Existente